

This document has been downloaded from:



The largest resource for amusement machines
documentation on the world wide web!




FLIPPERSPILL.COM

SEGA


n - SUB

Service Manual & Parts Catalog

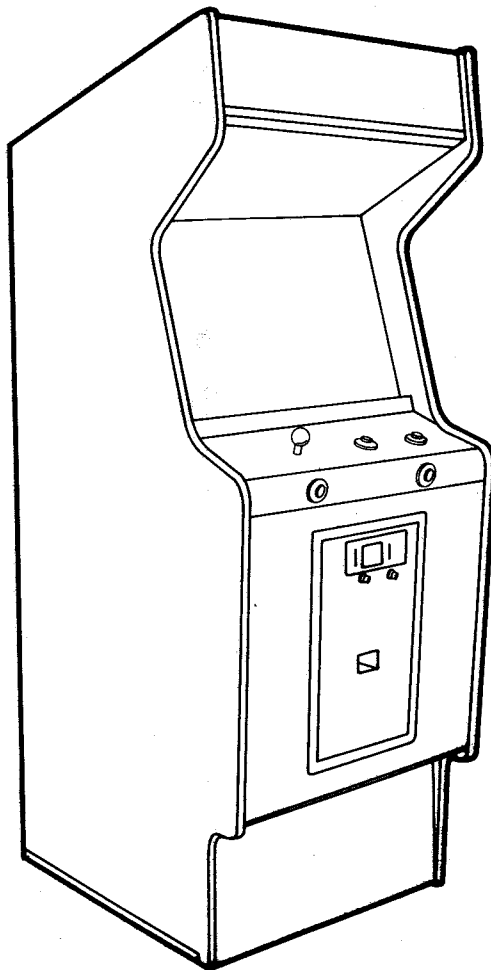

SEGA ENTERPRISES LTD.


3. IC Board (97201-P) Adjustments Coin Calculator

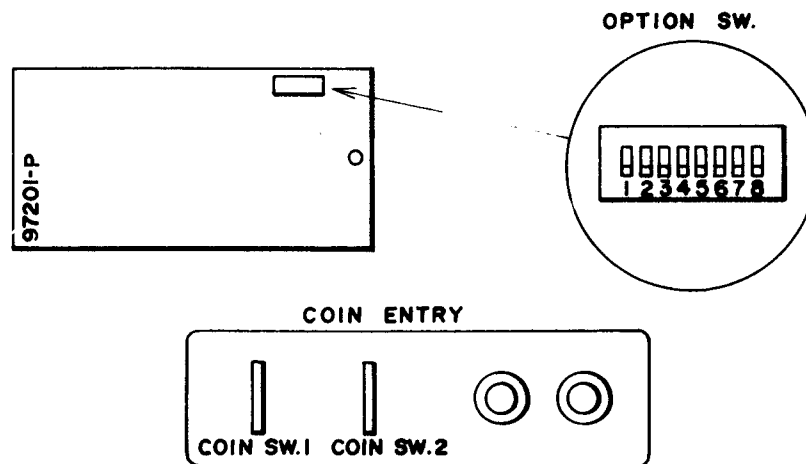



		ON: 0 OFF: X							
		OPTION							
COIN SW. 1	1 Coin 1 Play	0	X	X					
	2 Coins 1 Play	X	0	X					
	3 Coins 1 Play	0	0	X					
	4 Coins 1 Play	X	X	0					
	5 Coins 1 Play	0	X	0					
	6 Coins 1 Play	X	0	0					
	7 Coins 1 Play	0	0	0					
COIN SW. 2	1 Coin 1 Play	0	X	X				0	
	2 Coins 1 Play	X	0	X				0	
	3 Coins 1 Play	0	0	X				0	
	4 Coins 1 Play	X	X	0				0	
	5 Coins 1 Play	0	X	0				0	
	6 Coins 1 Play	X	0	0				0	
	7 Coins 1 Play	0	0	0				0	
COIN SW. 2	1 Coin 1 Play				0	X	X	X	
	1 Coin 2 Plays				X	0	X	X	
	1 Coin 3 Plays				0	0	X	X	
	1 Coin 4 Plays				X	X	0	X	
	1 Coin 5 Plays				0	X	0	X	
	1 Coin 6 Plays				X	0	0	X	
	1 Coin 7 Plays				0	0	0	X	

NOT USED




Cabinet Accessory Assy

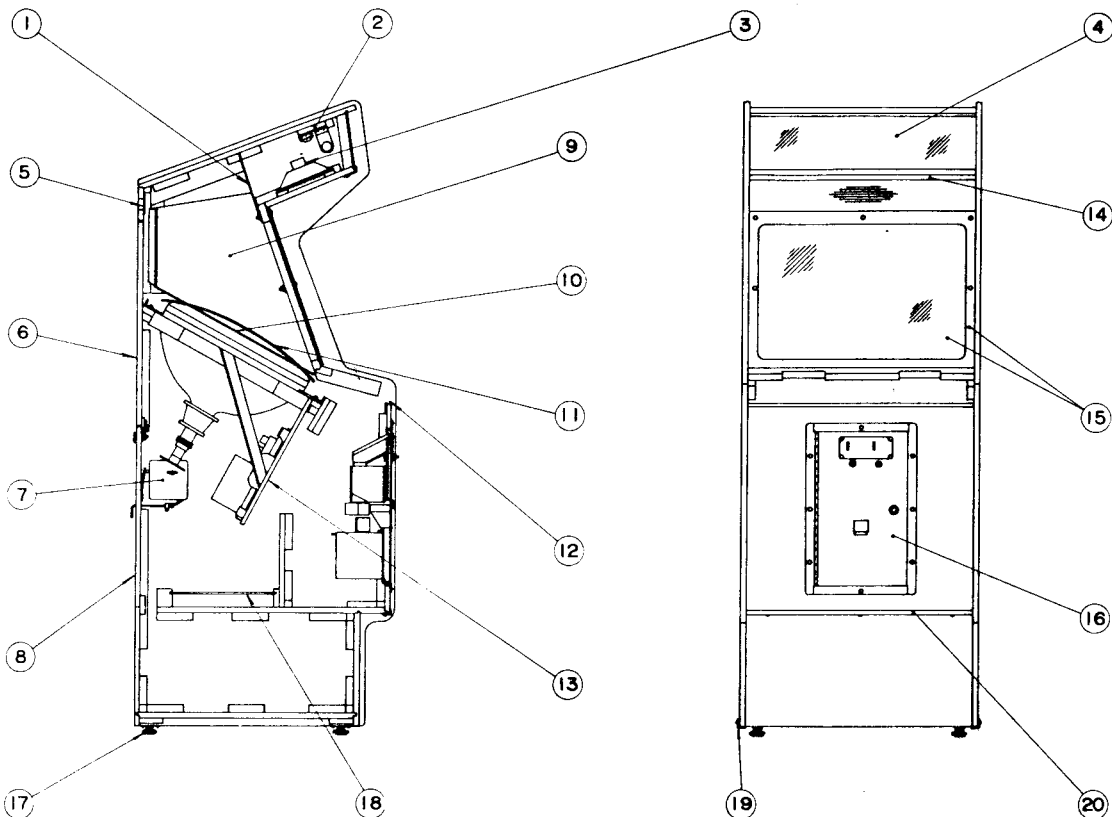

- 1 MR-1015 Light Baffle
- 2 NS-1039 FLUORESCENT LIGHT ASSY, 15W
- 3 S-90201 Fluorescent Light, 15W
- 4 MR-1009 Speaker Guard Plate
- 5 S-97336 Speaker, 230 x 150mm, 8Ω, 6W
- 6 NS-1028 Top Panel
- 7 TA-1065X Nut Plate
- 8 PT-0015 Net
- 9 MR-1002 Back Door, Upper
- 10 MR-1019 JUNCTION BOX ASSY
- 11 NS-1037 JUNCTION BOX ASSY, 200~240V
(See Page 14 for Detail)
- 12 NS-1038 Back Door, Lower
- 13 NS-1034 Scenery, Right
- 14 NS-1035 Scenery, Left
- 15 NS-1033 Scenery, Rear
- 16 MR-1024 TV Mask
- 17 MR-1005 Trim, Upper
- 18 97232-P COLOR DISPLAY ASSY, 20TYPE, 120V
- 19 97397-P COLOR DISPLAY ASSY, 20TYPE, 100V
- 20 MR-1007 Ornament Frame
- 21 MR-1013 Window Panel
- 22 MR-1014 Bezel Frame
- 23 MR-1200 COIN CHUTE DOOR & CASH BOX ASSY
(See Page 16 for Detail)
- 24 M-163-4(L) Leg Adjuster
- 25 Leg Adjuster Bracket
- 26 97399-P-16 IC BOARD ASSY, N-SUB
- 27 NS-1036 Corner Protector
- 28 MR-1006 Trim, Lower

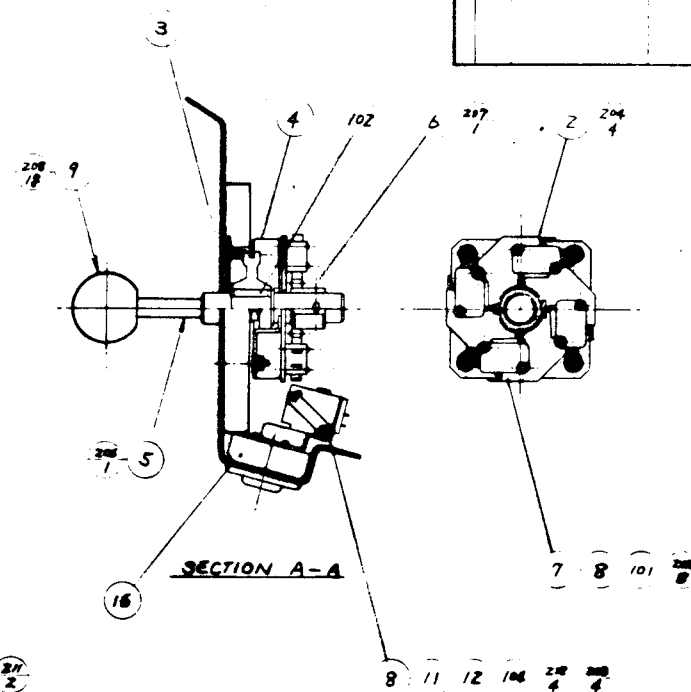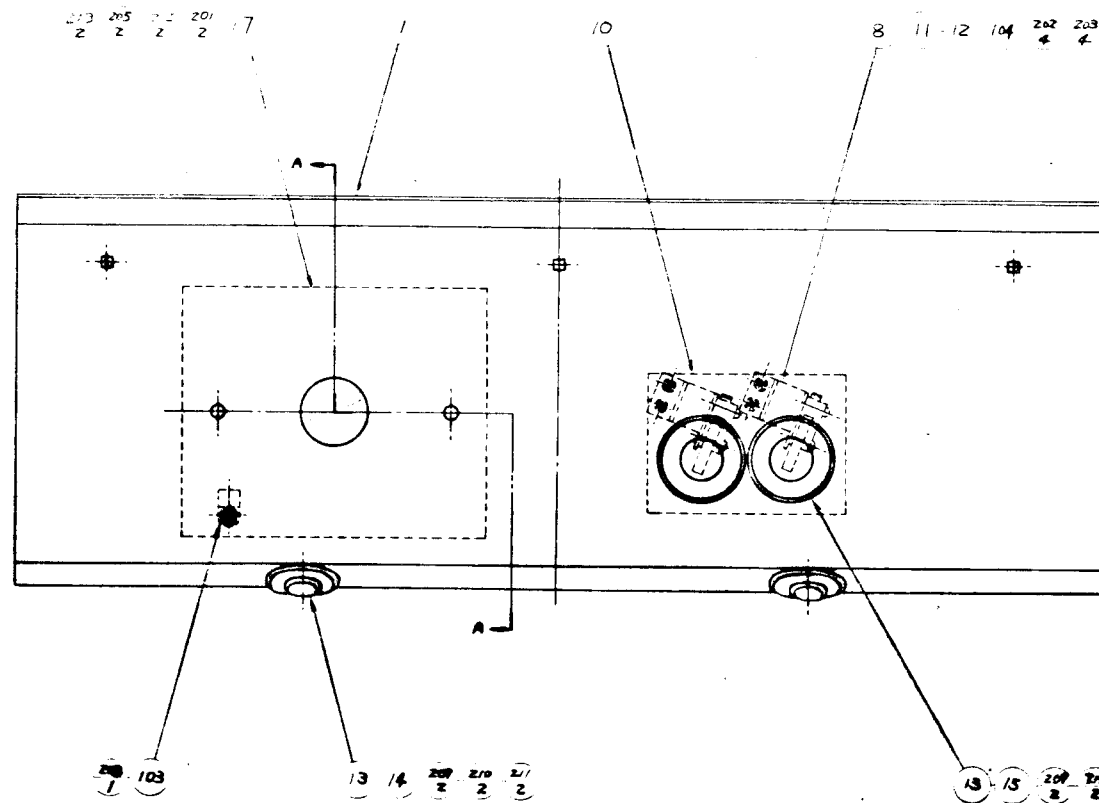


SEGA ENTERPRISES LTD.		THIS DRAWING IS A COPY OF THE ORIGINAL AND IS NOT TO BE USED FOR REPRODUCTION	
LIMITS UNLESS OTHERWISE SPECIFIED		SCALE	1/2
DRAWN BY		CHK'D	CRW
INTERNAL	HEAT TREAT	FINISH	REMARK

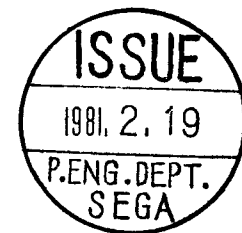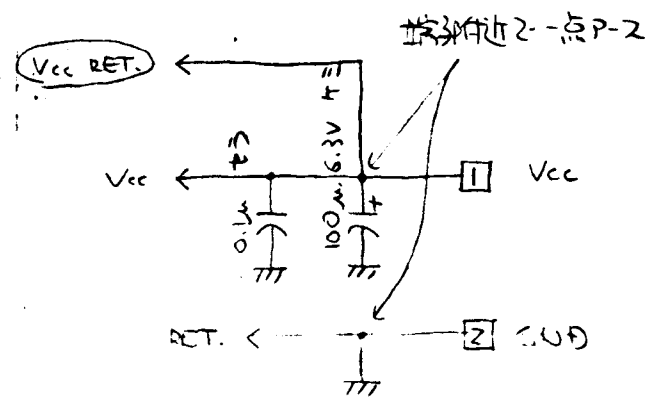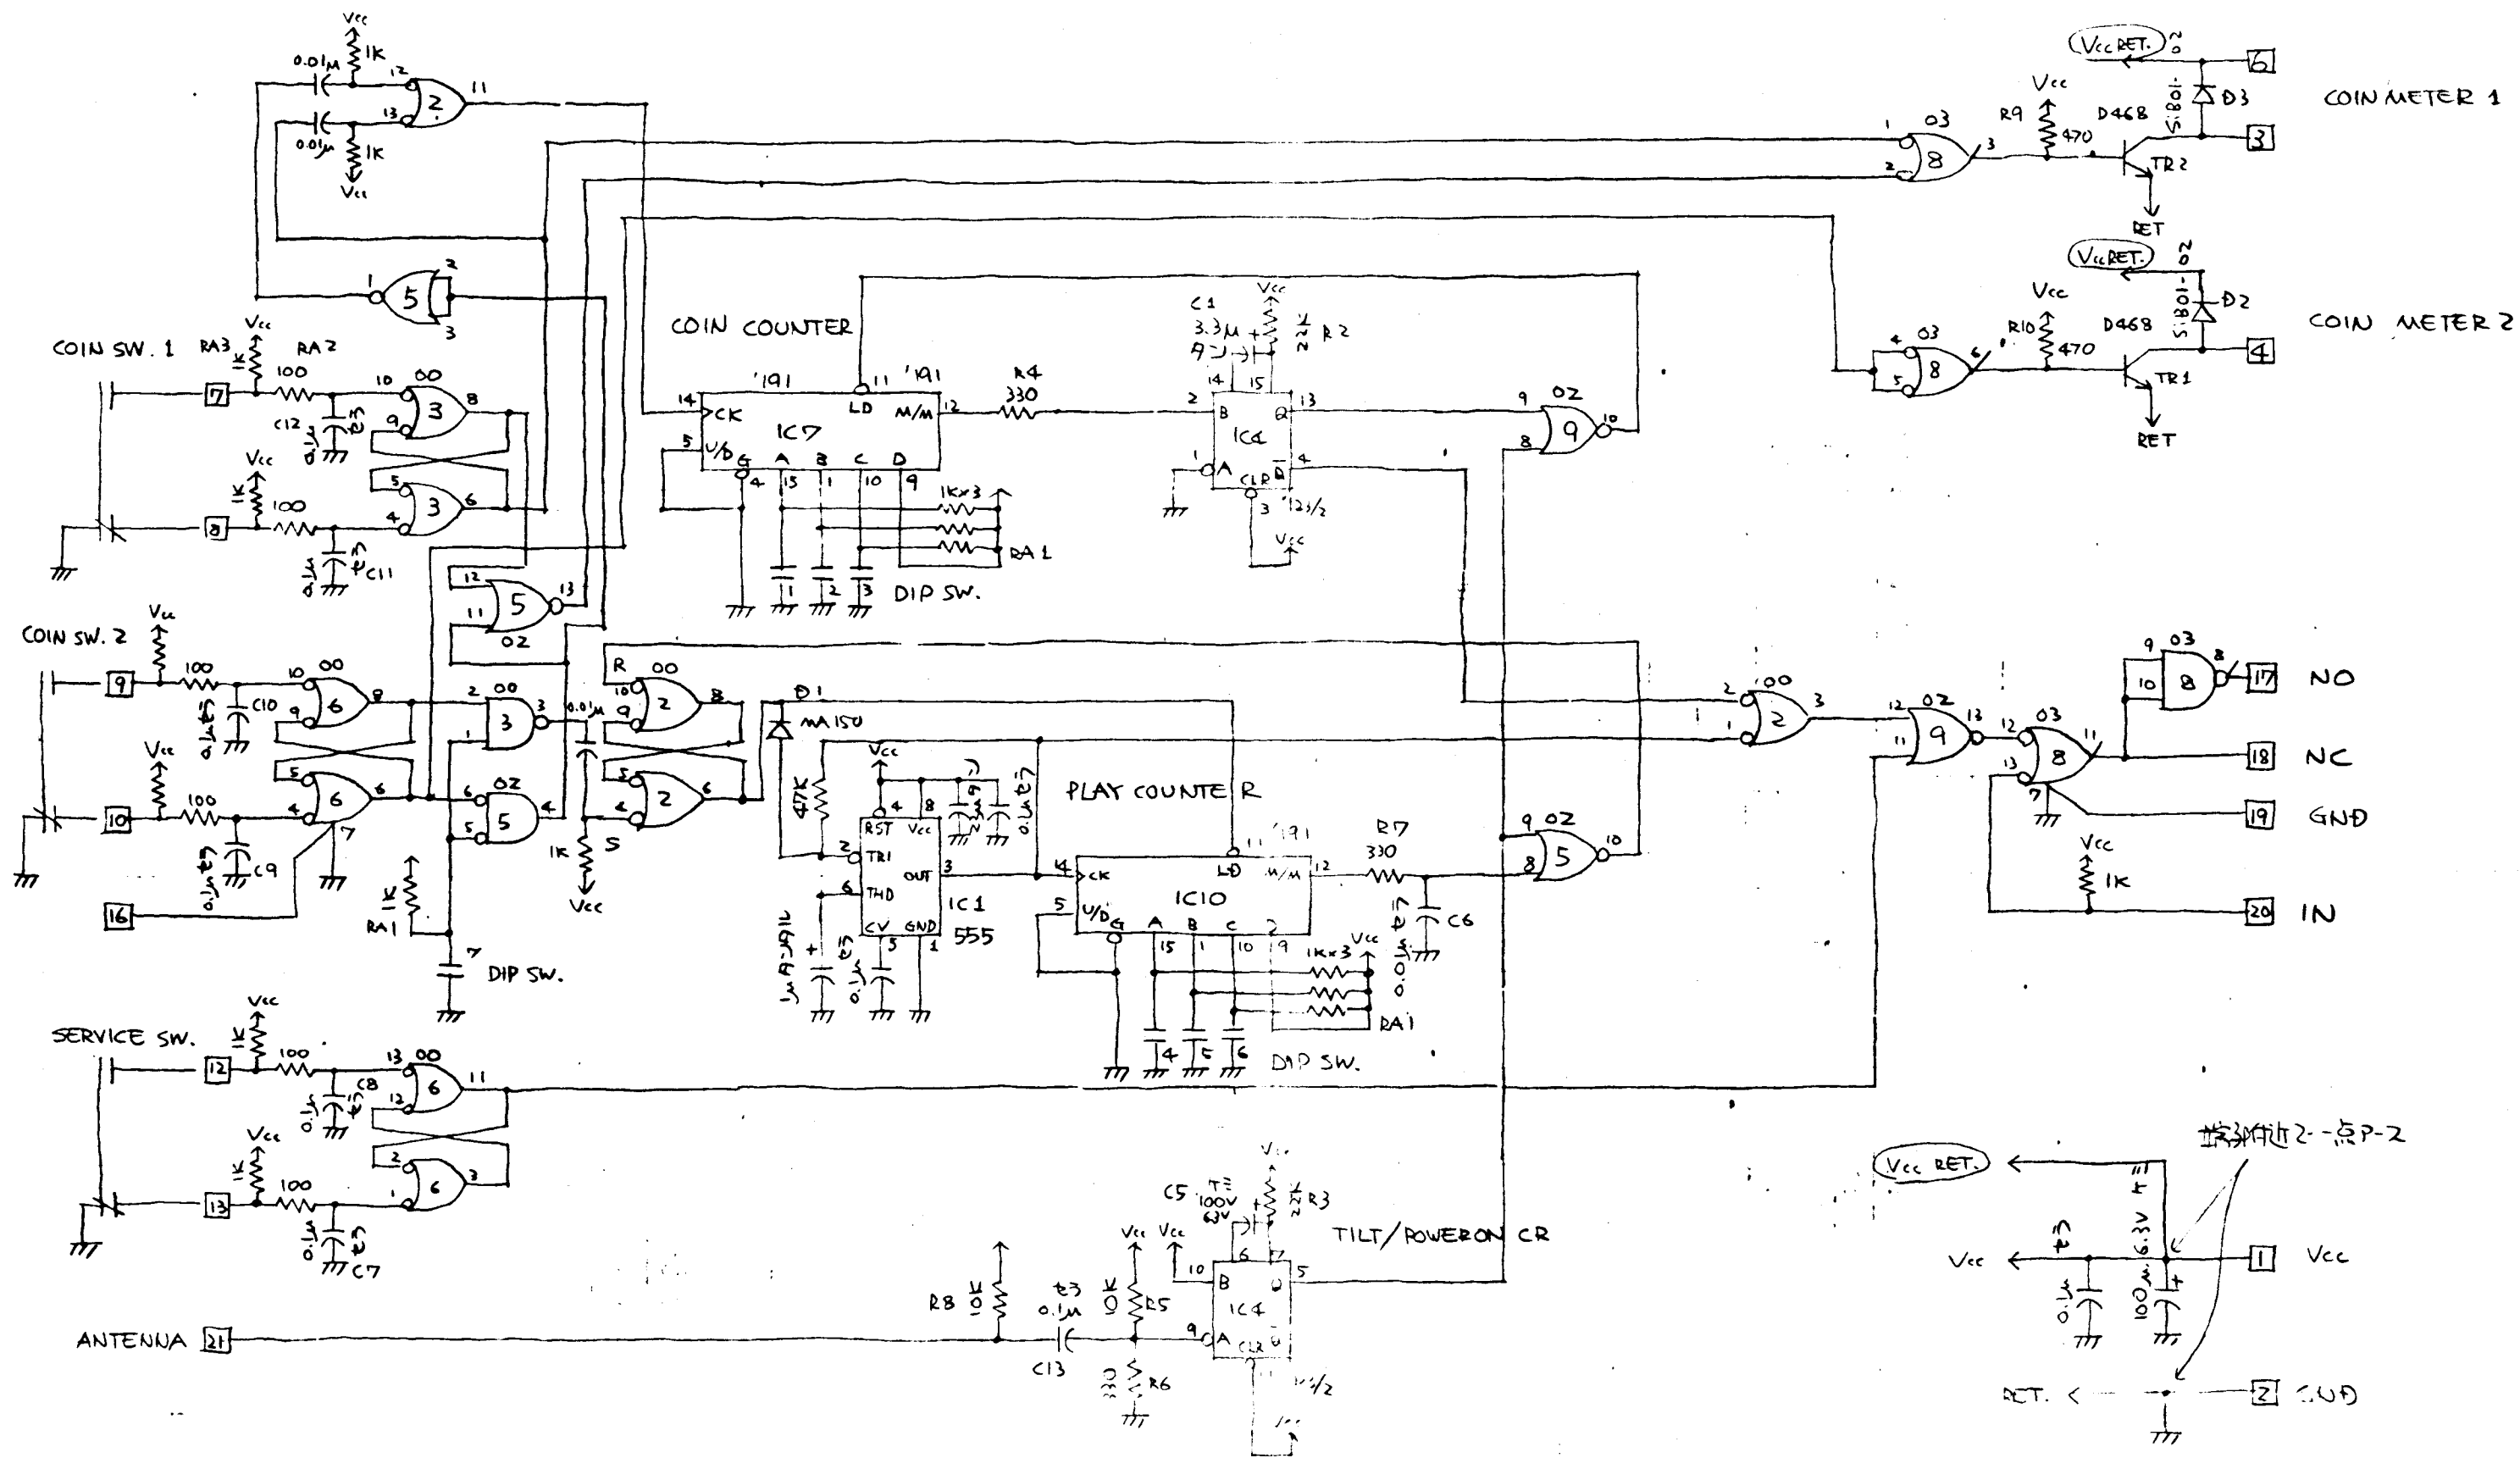

△ C1 0.01VOLD. 100
△ 11/17-20
11/20-20

97201-P COIN CALCULATOR, LOGIC DIAGRAM

10.31232MHZ
15.46848MHZ

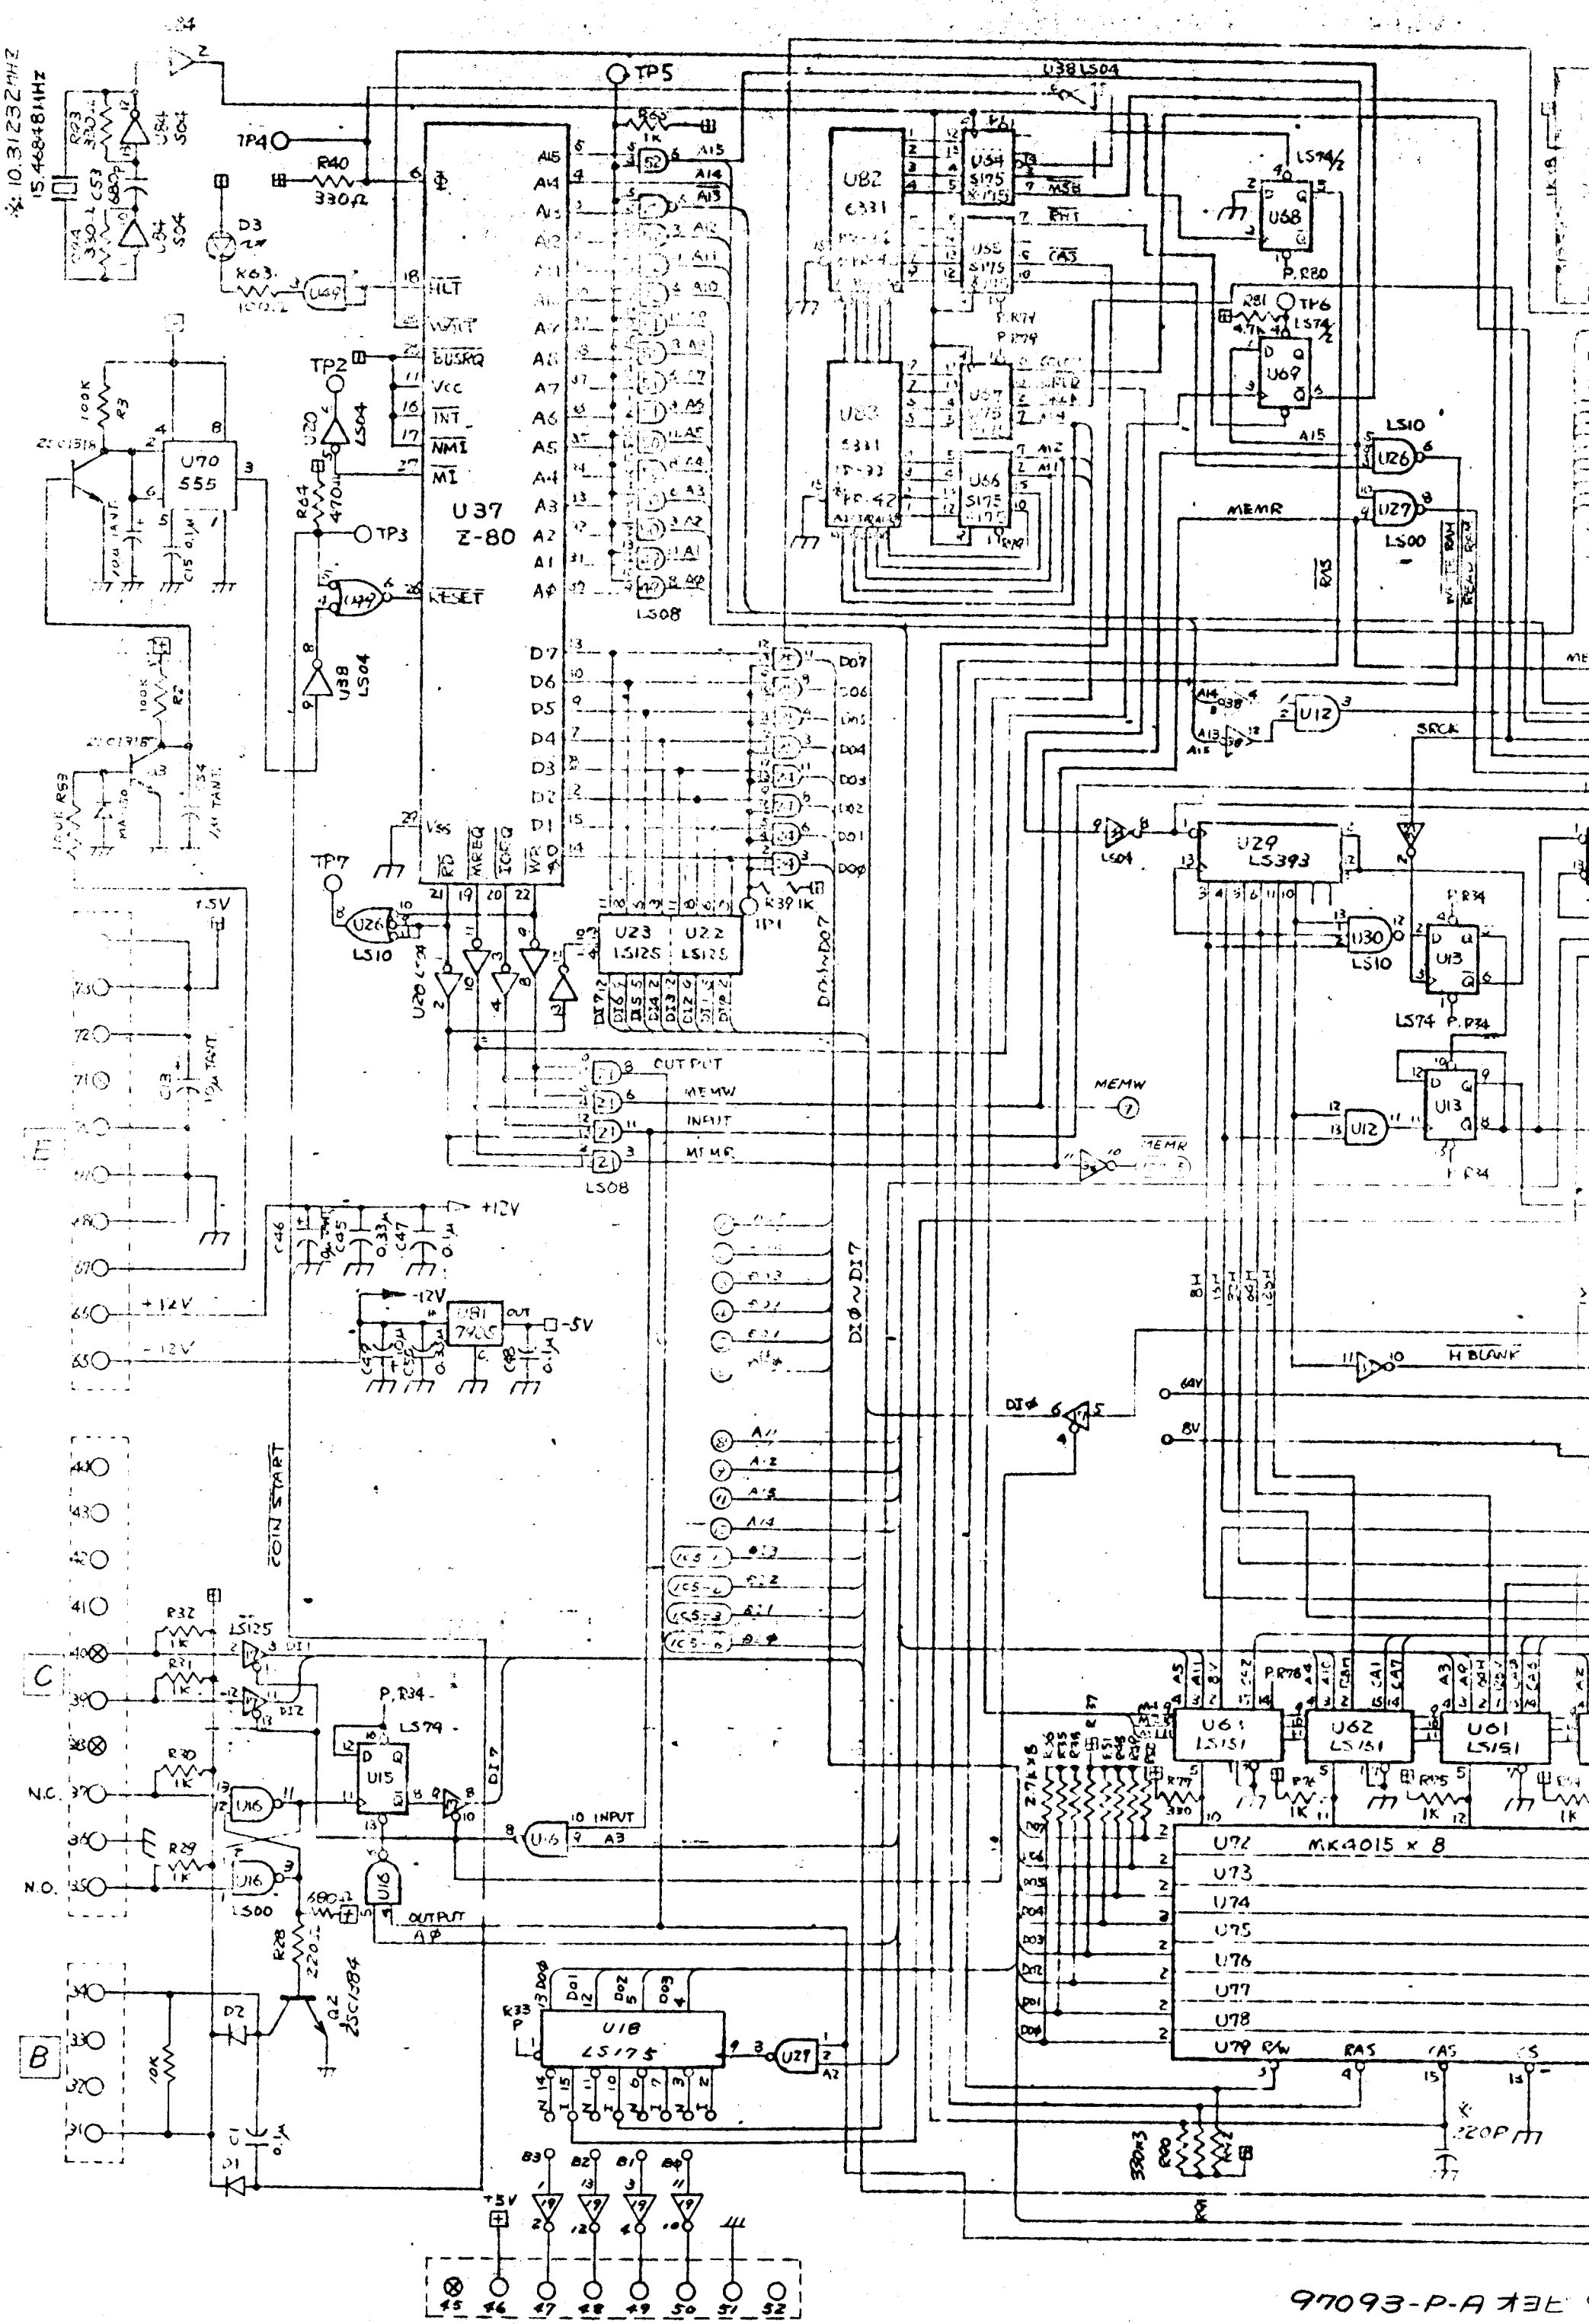

6

5

4




3

2

G






F


E

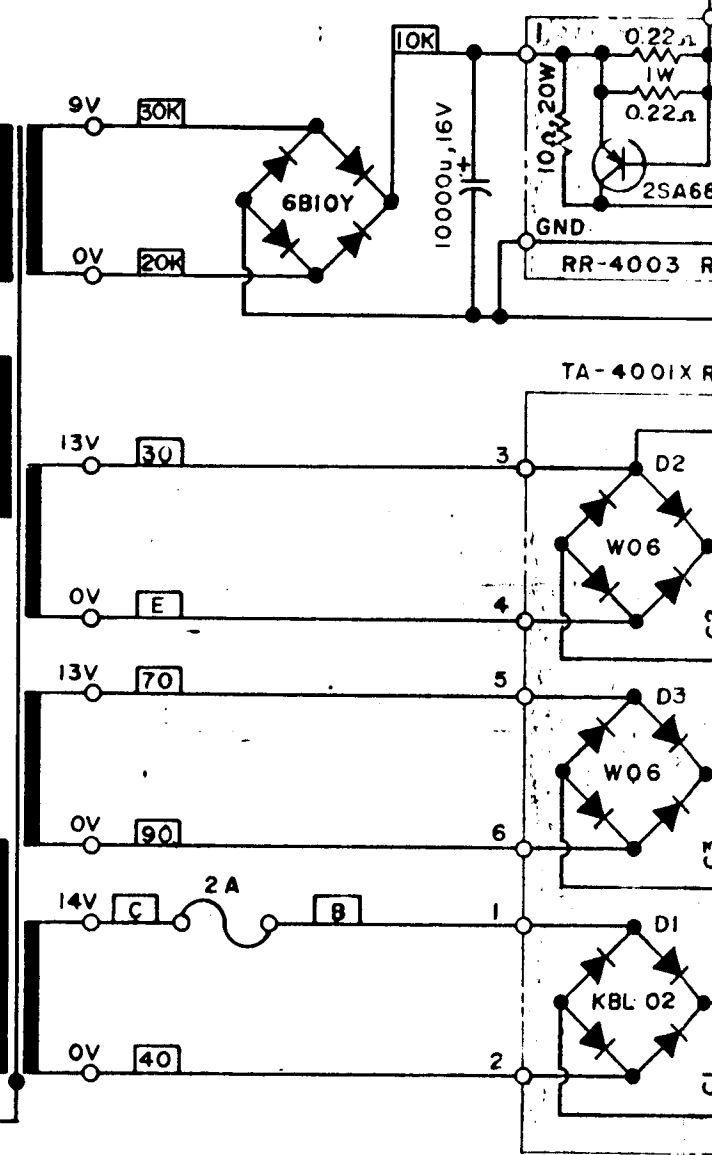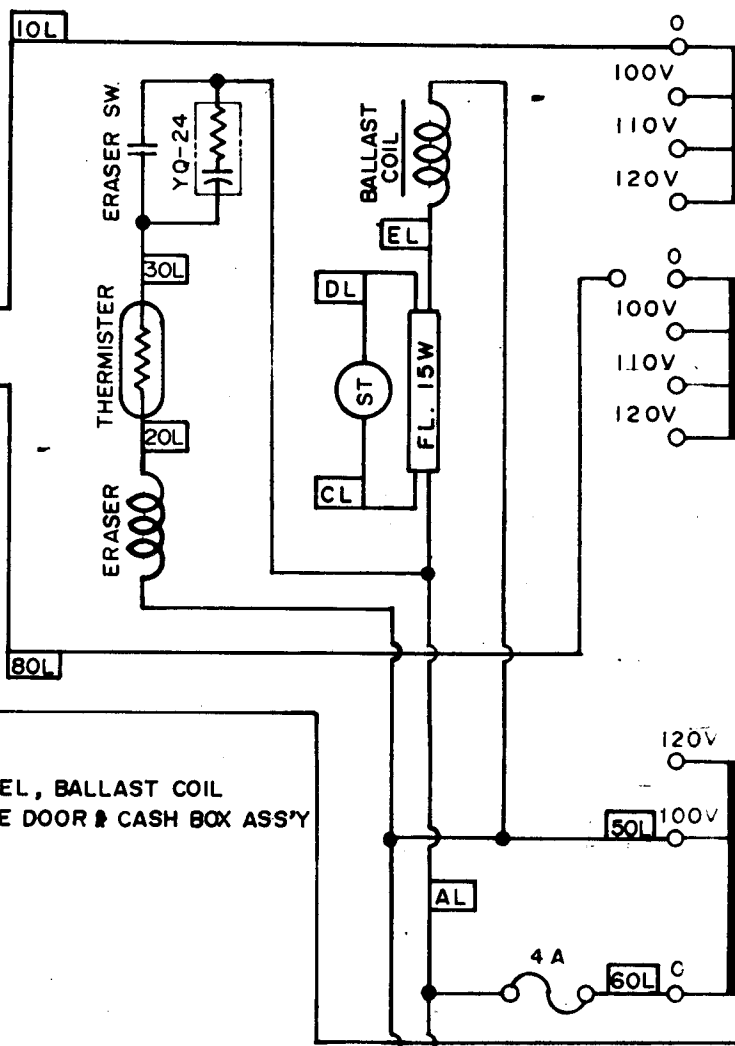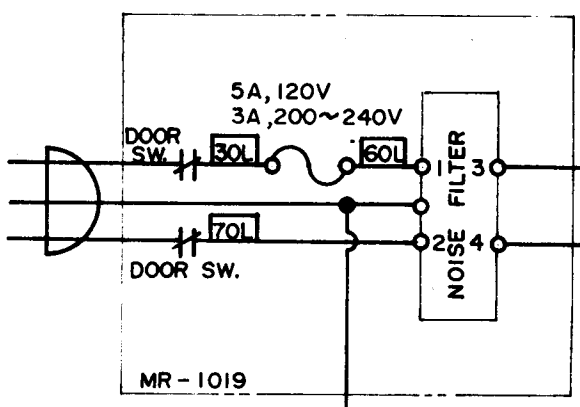


FRONT PANEL, BALLAST COIL
COIN CHUTE DOOR & CASH BOX ASS'Y

S-97399-P-16
97399-P-16 IC BOARD ASS'Y, CONNECTOR LOCATION

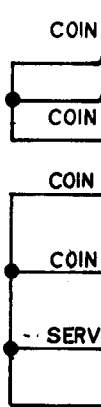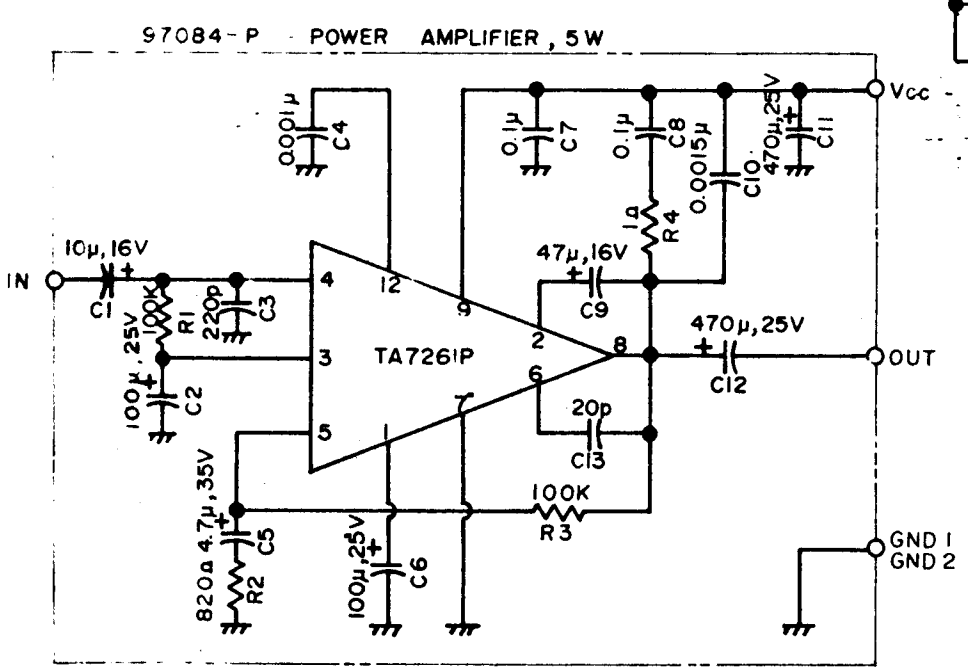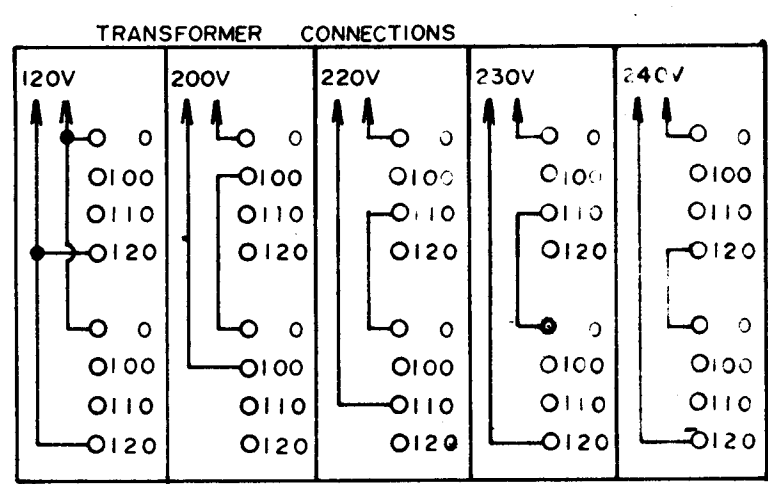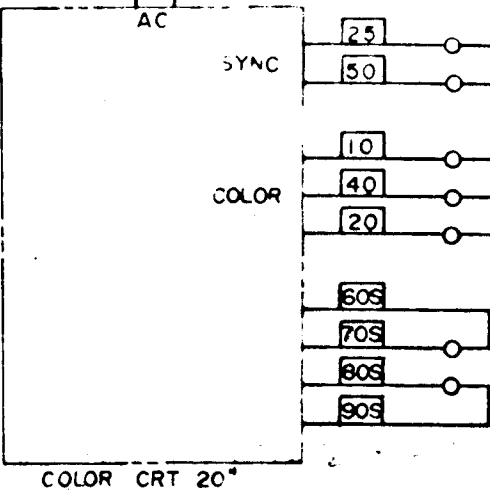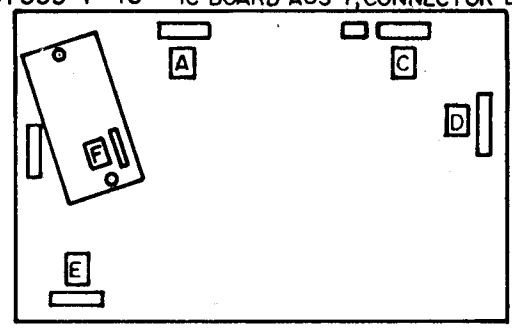

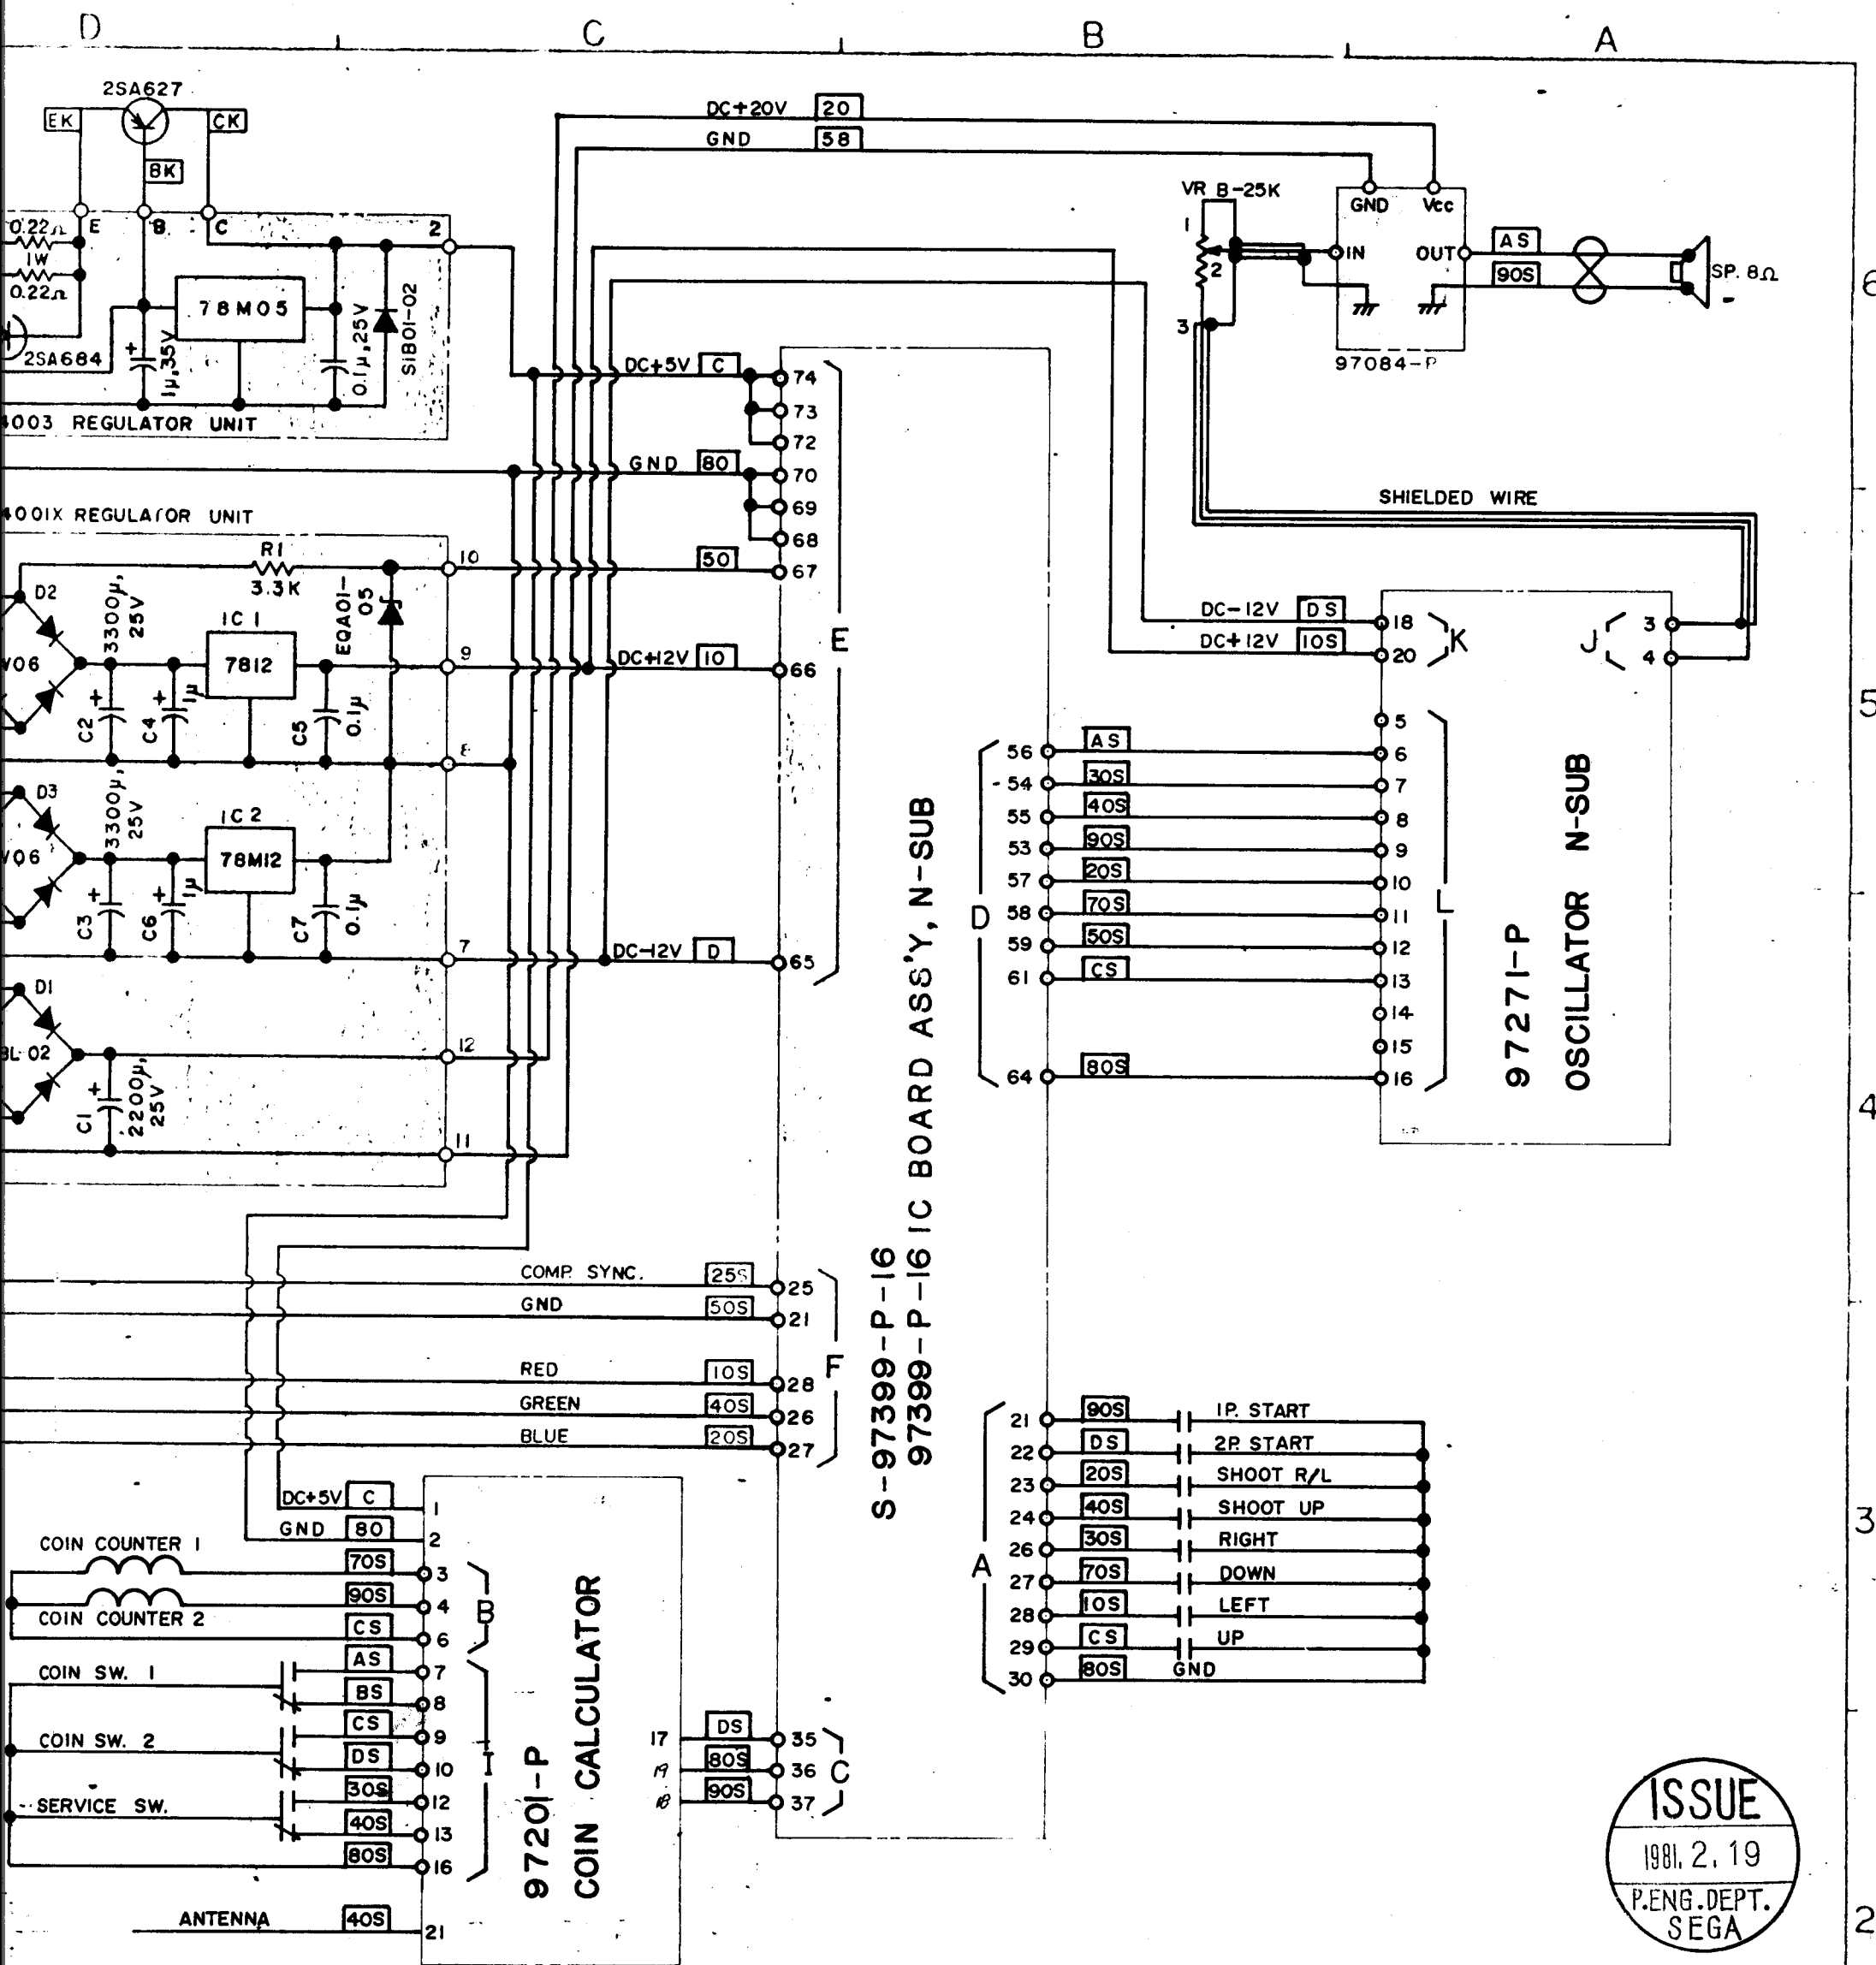

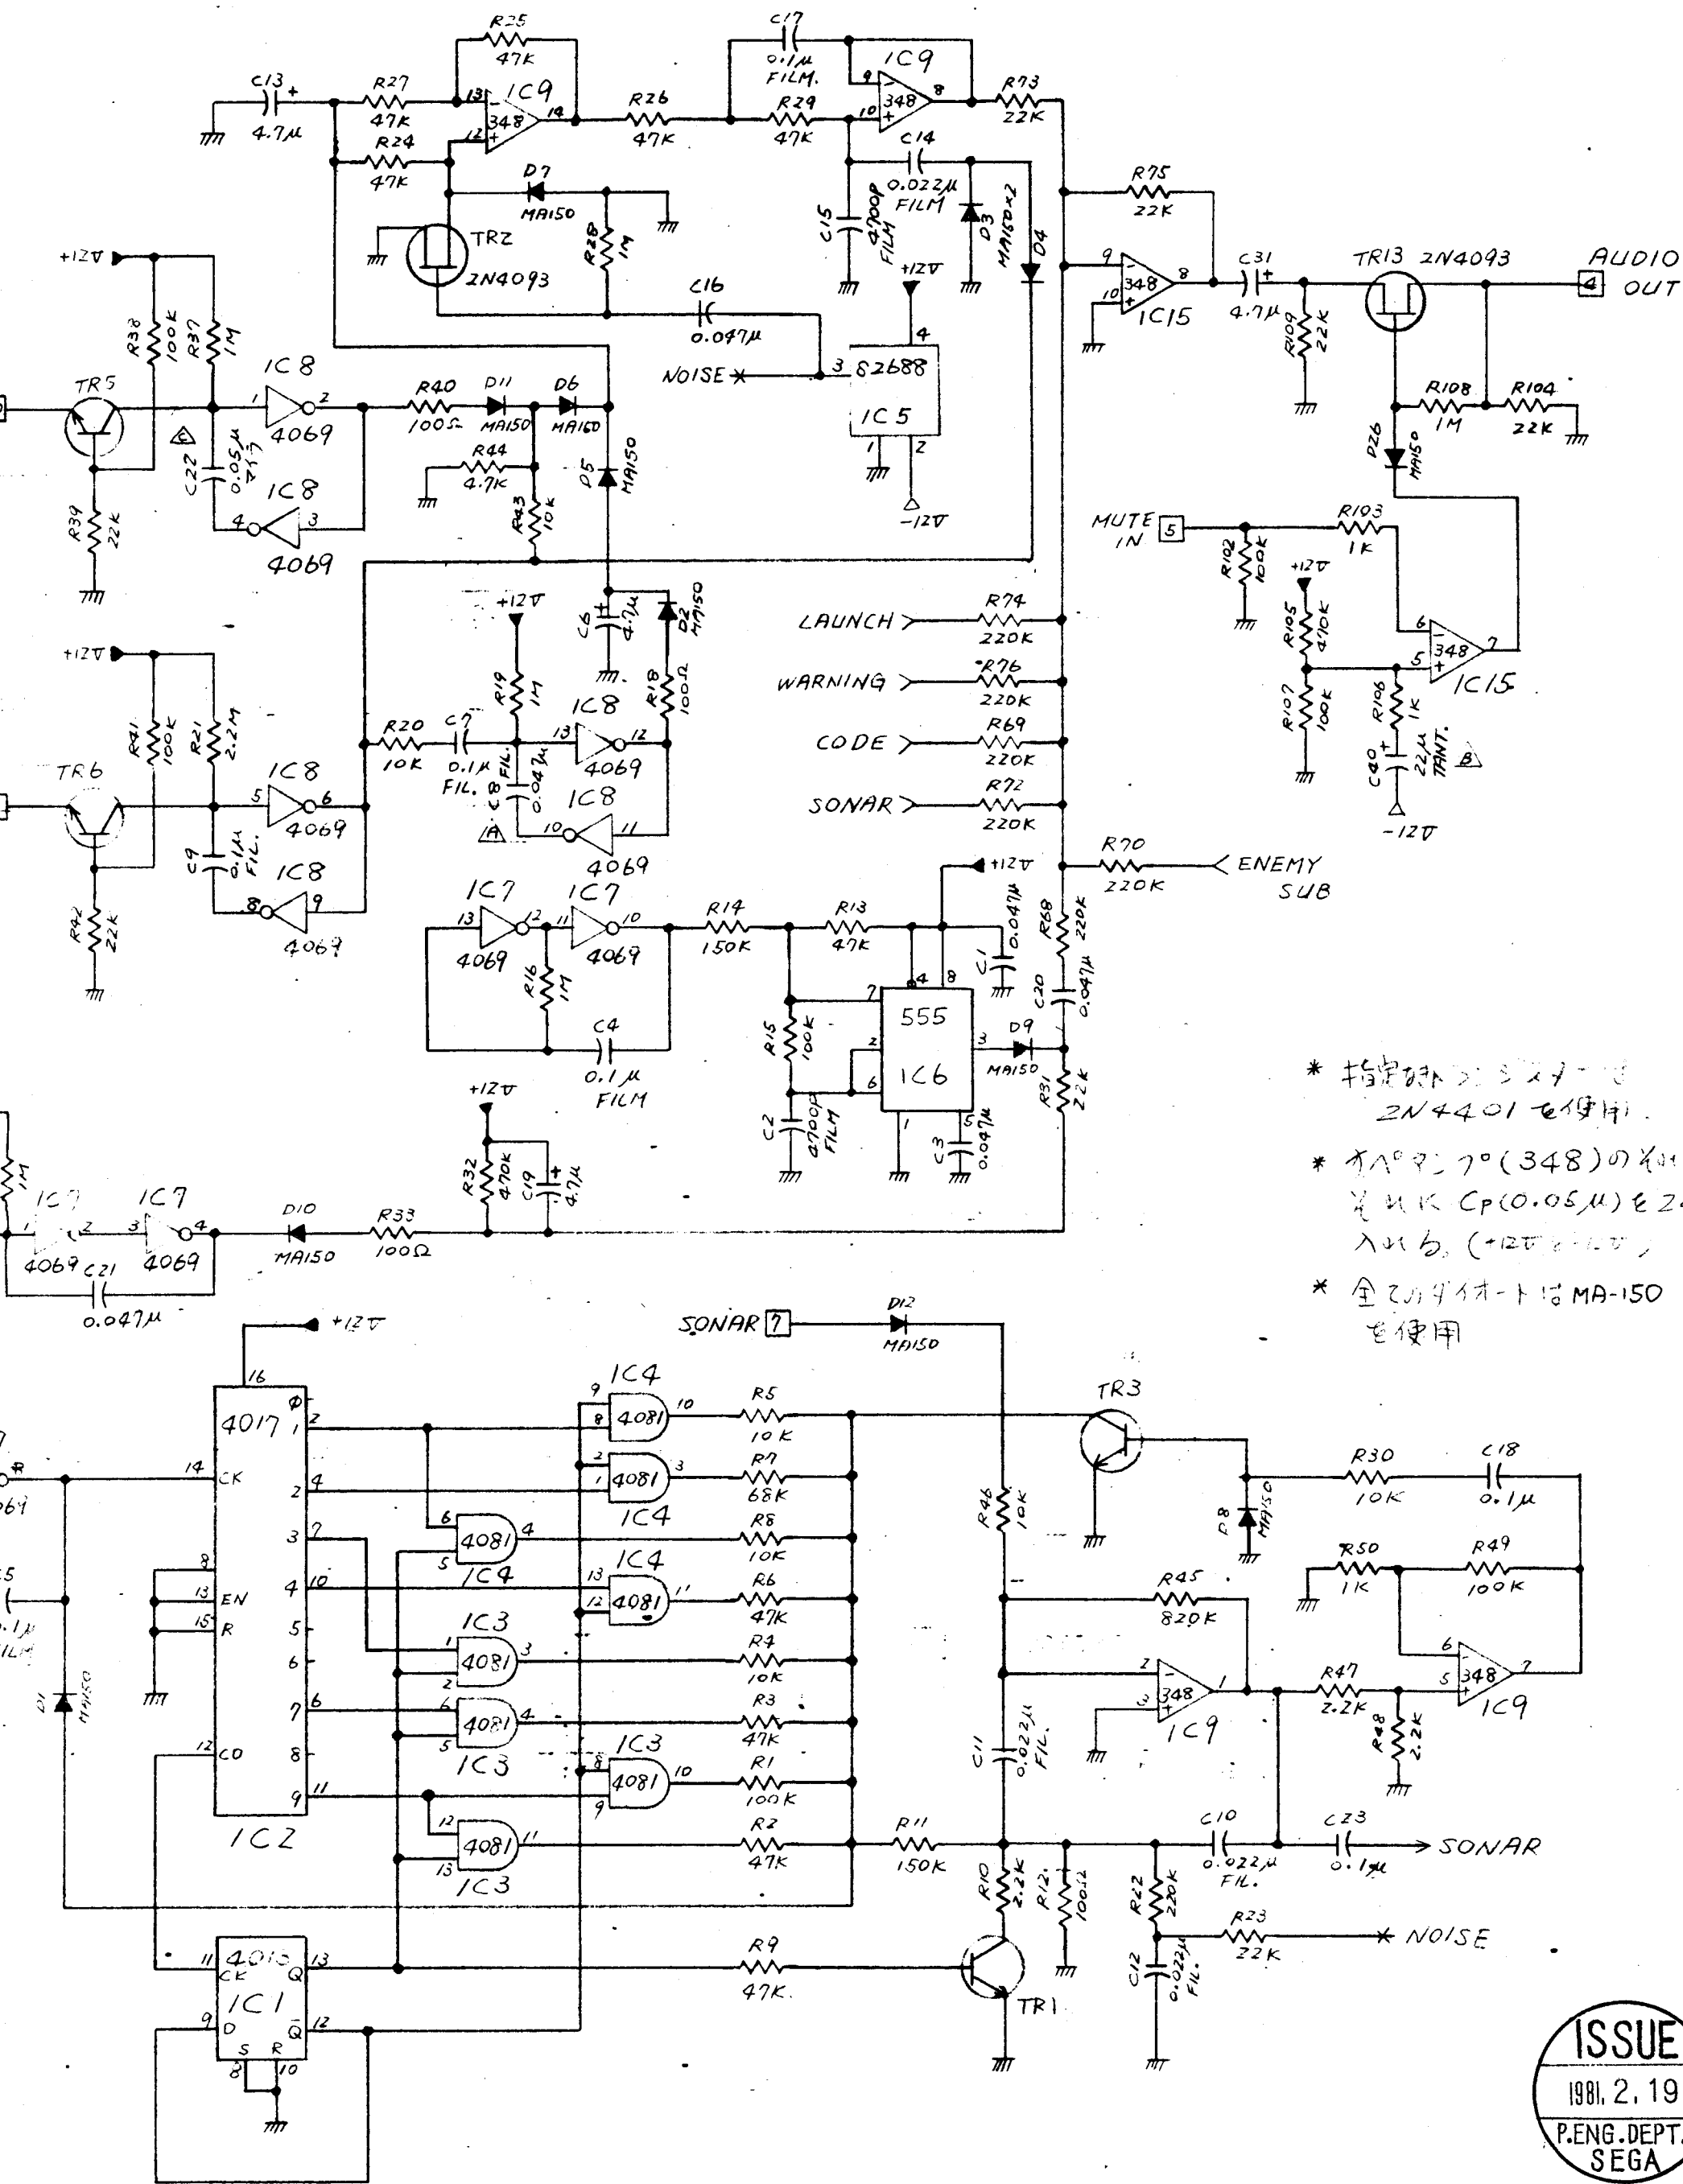

- * 指定部品は2N401を使用。
- * 4069 (348) の C_p (0.05 μ) を 24 μ にし、(+12V, -12V) に入力。
- * 全ての部品は MA-150 を使用。

ISSUE
1981. 2. 19
P.ENG.DEPT.
SEGA

△ C22 WAS 27 1/2-80 ~~402~~
△ C40 WAS 47 1/2-80 ~~402~~
△ C6 WAS 27 1/2-80 ~~402~~

10. 14 1981
10/8-80 ~~402~~
10/12-80 ~~402~~

LLATOR N-SUB